


SYMBOL	DEVICE
MS	MAIN RING SPEAKER
SS	SURROUND SPEAKER
PS	PLAYBACK SPEAKERS
S	BACK STAGE CEILING SPEAKER
H	BACK STAGE HORN SPEAKER
S	BACK STAGE WALL MOUNT SPEAKER
SV	SPEAKER WITH BUILT IN VOLUME CONTROL
V	VOLUME CONTROL
NS	VOLUME CONTROL W/ 2-WAY SWITCH
M	MONITOR MIC
PM	PAGE MIC
S	LOBBY (PROMENADE) SPEAKER
C	IR CAMERA
CM	CAMERA VIDEO MONITOR
T	TE LINE PLATE
M8	MIC PLATE-8 JACK
S1	SPEAKER PLATE-1 JACK
S2	SPEAKER PLATE-2 JACK
N2	CATSE (NETWORK) PLATE-2 JACK
N4	CATSE (NETWORK) PLATE-4 JACK
N6	CATSE (NETWORK) PLATE-6 JACK
I2	INTERCOM PLATE-4 CHANNEL
I1	INTERCOM PLATE
I3	INTERCOM REMOTE STATION PLATE
HI	INTERCOM HEADSET STATION
HP	HOUSE PLATE
[ ]	EXISTING DEVICE

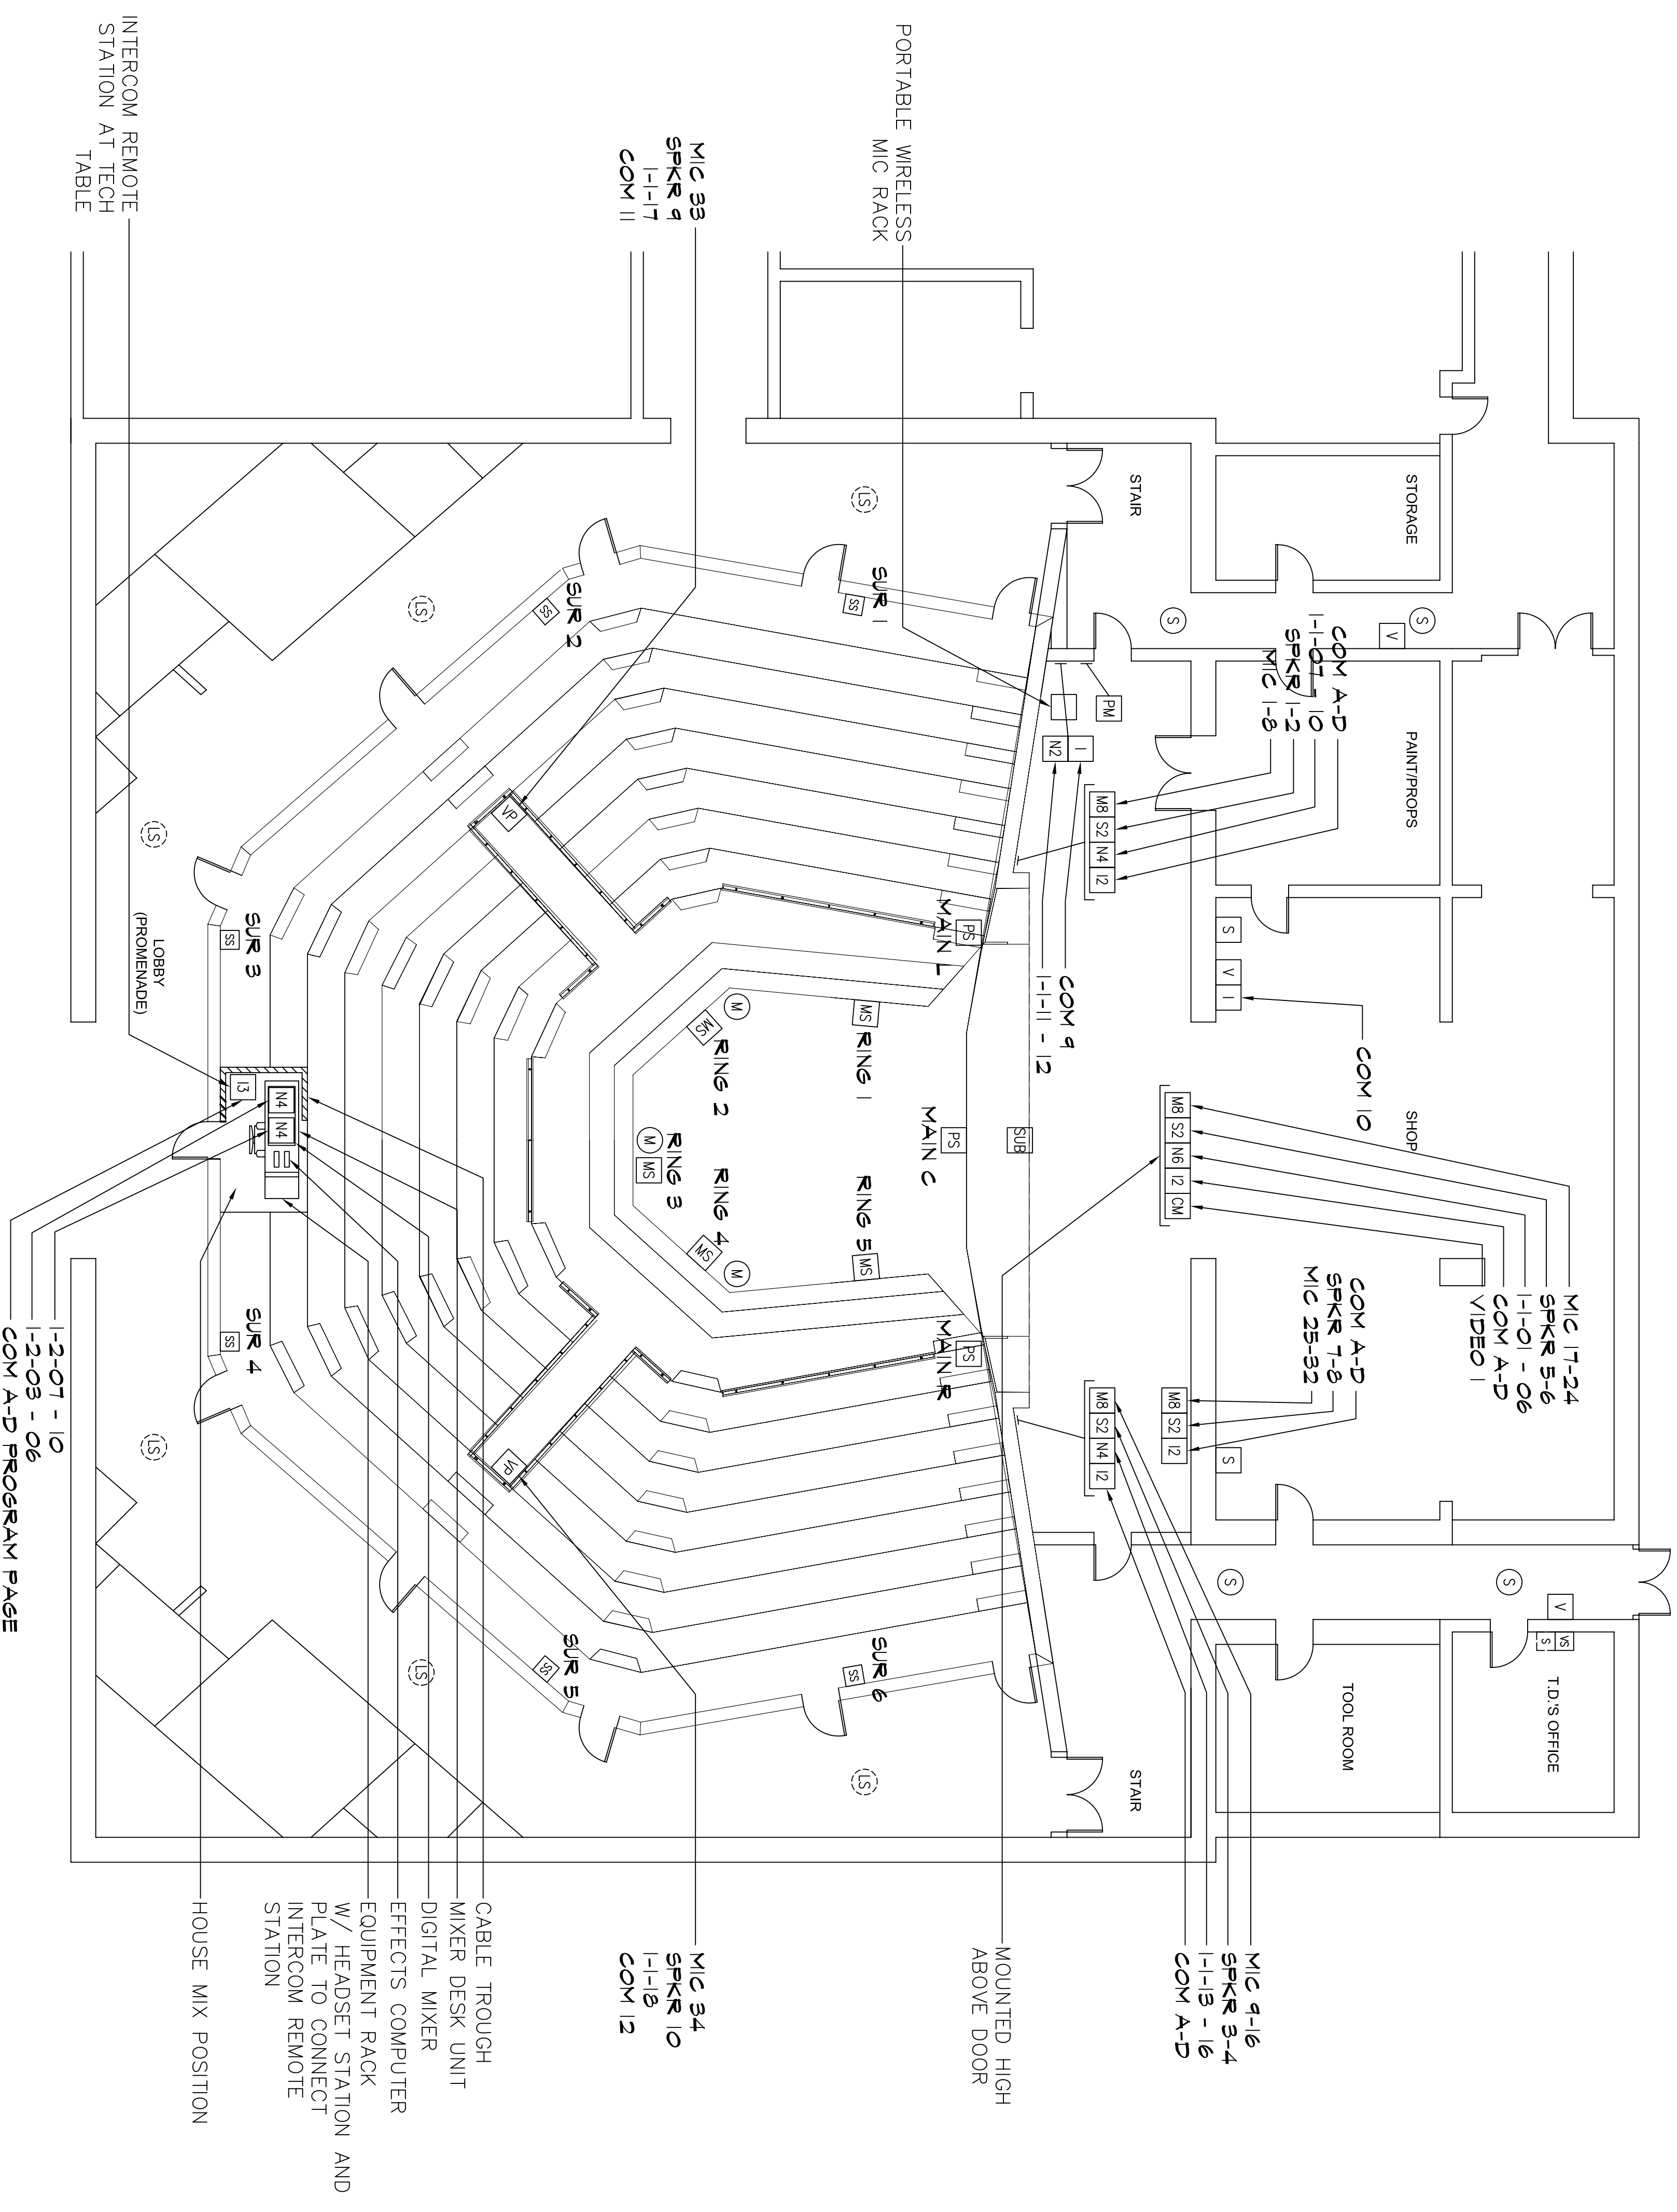

1 FIRST FLOOR - A/V LAYOUT WITH CIRCUIT NUMBERS  
AV-1 1/8"=1'-0"

HOUSE MIX POSITION  
W/ HEADSET STATION AND  
INTERCOM REMOTE  
EQUIPMENT RACK  
EFFECTS COMPUTER  
DIGITAL MIXER  
MIXER DESK UNIT  
CABLE TROUGH

Mark	Date	Description
ASB	6/13/07	AS-BUILT
REV 2	6/13/07	
REV 1	5/10/07	
DATE	5/10/07	

Drawn By: NCV Checked By: JDL

AV LAYOUT  
1ST FLOOR

AV-1