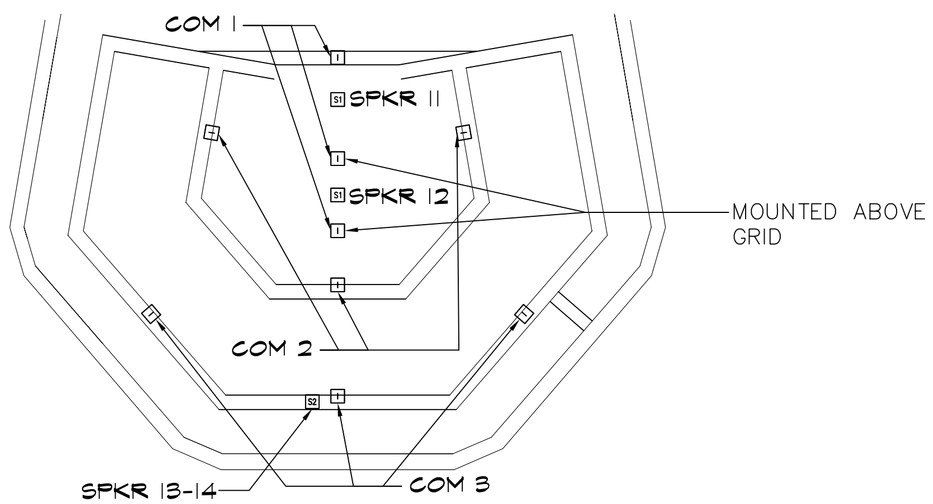

3 / AV-2 CATWALK – A/V LAYOUT WITH CIRCUIT NUMBERS
1/16"=1'-0"

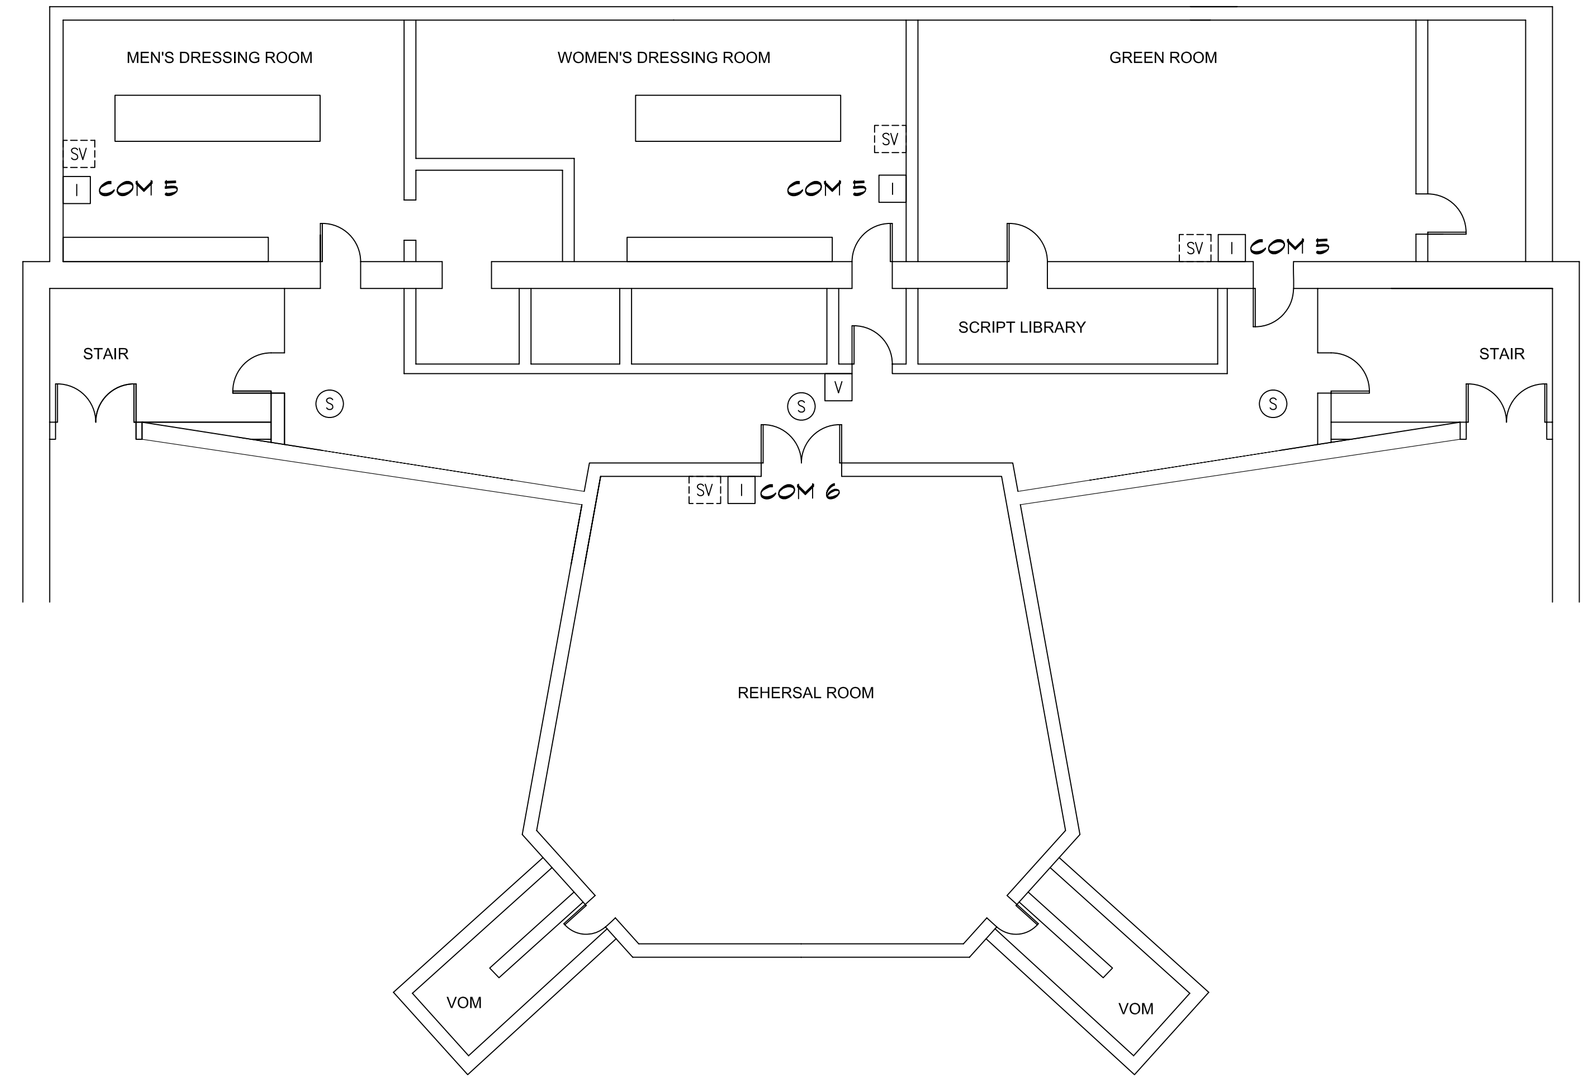

1 / AV-2 LOWER LEVEL – A/V LAYOUT WITH CIRCUIT NUMBERS
1/8"=1'-0"

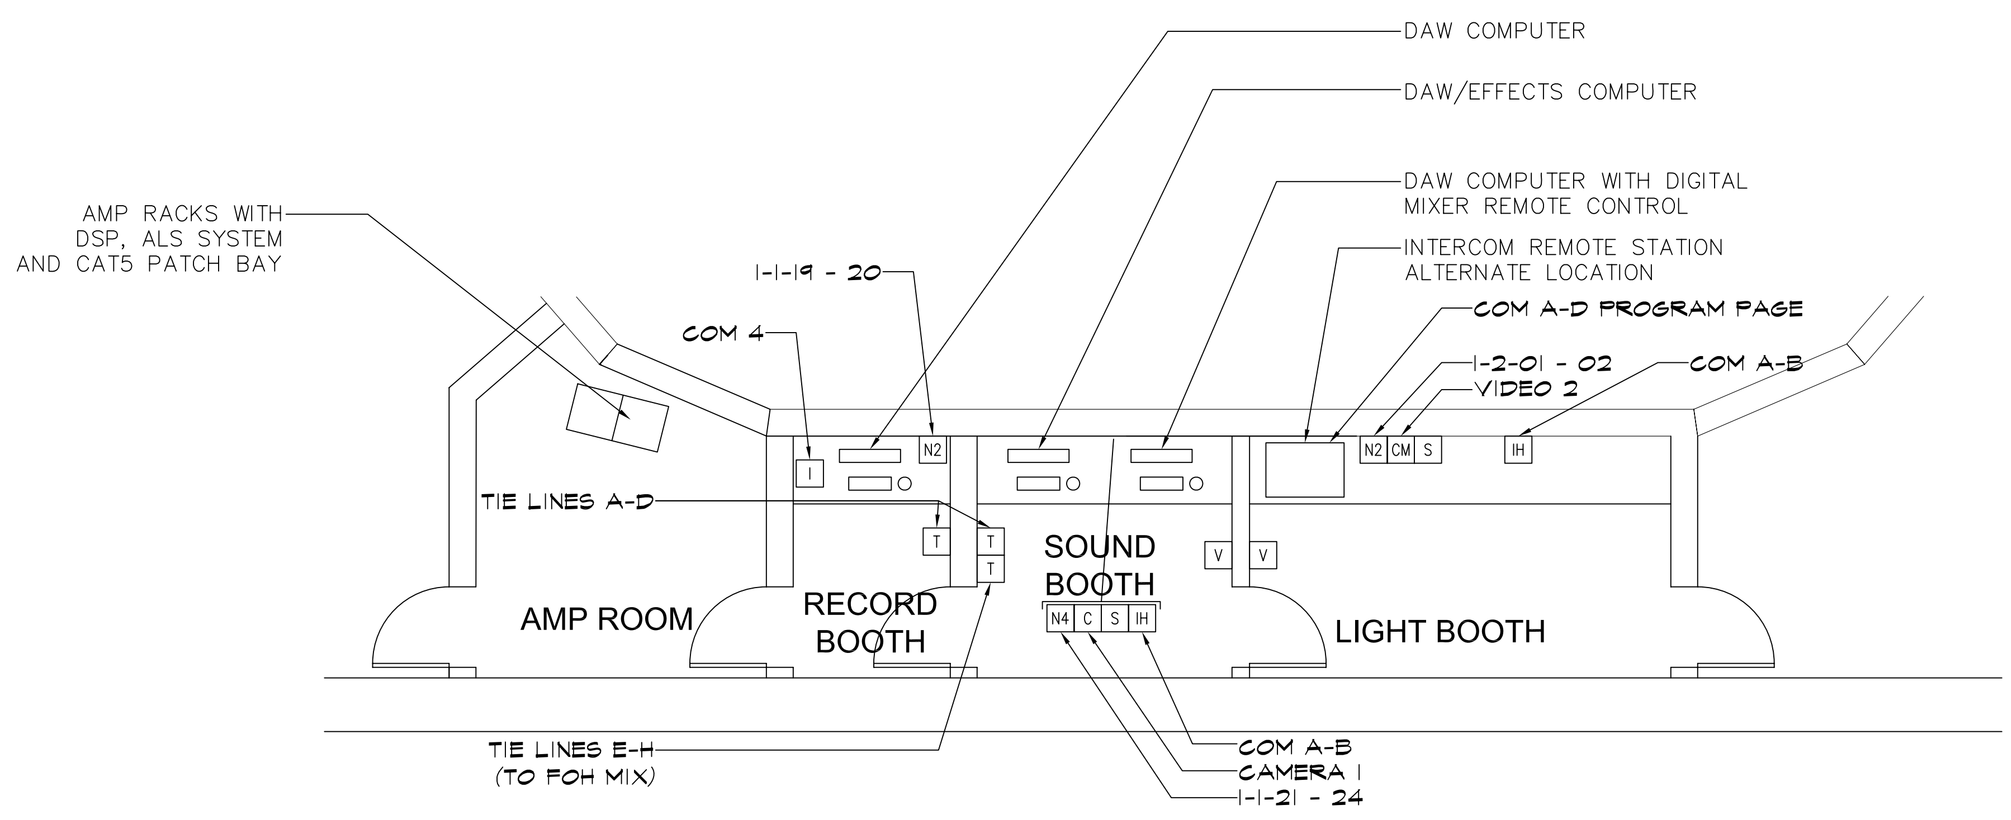

2 / AV-2 CONTROL ROOM – A/V LAYOUT WITH CIRCUIT NUMBERS
1/4"=1'-0"

A/V EQUIPMENT SCHEDULE

SYMBOL	DEVICE
MS	MAIN RING SPEAKER
SS	SURROUND SPEAKER
PS	PLAYBACK SPEAKERS
S	BACK STAGE CEILING SPEAKER
H	BACK STAGE HORN SPEAKER
S	BACK STAGE WALL MOUNT SPEAKER
SV	SPEAKER WITH BUILT IN VOLUME CONTROL
V	VOLUME CONTROL
VS	VOLUME CONTROL W/ 2-WAY SWITCH
M	MONITOR MIC
PM	PAGE MIC
LS	LOBBY (PROMENADE) SPEAKER
C	IR CAMERA
CM	CAMERA VIDEO MONITOR
T	TIE LINE PLATE
M8	MIC PLATE-8 JACK
S1	SPEAKER PLATE-1 JACK
S2	SPEAKER PLATE-2 JACK
N2	CAT5E (NETWORK) PLATE-2 JACK
N4	CAT5E (NETWORK) PLATE-4 JACK
N6	CAT5E (NETWORK) PLATE-6 JACK
I2	INTERCOM PLATE-4 CHANNEL
I	INTERCOM PLATE
I3	INTERCOM REMOTE STATION PLATE
IH	INTERCOM HEADSET STATION
VP	VOM PLATE
HP	HOUSE PLATE
[ ]	EXISTING DEVICE

Lipp AV Design, Inc.
CONSULTING IN SOUND & VIDEO SYSTEMS
Jeffrey Lipp
Principal Consultant
Phone: (847) 808-8790
Fax: (847) 808-8791
E-Mail: jeff@lippav.com
420 Mayfair Lane
Buffalo Grove, IL 60089
www.lippav.com

Richard B. Ingraham
RBI Computers and Audio
5020 Robinhood Dr., F-104
Willoughby, OH 44094
phone 440.942.2029

Chuck Meacham
University of Evansville Technical Director
1800 Lincoln Ave
Evansville, IN 47722
phone 812.479.2752

University of Evansville
Shanklin Theater
Sound System

ISSUE/REVISION

Mark	Date	Description
	5.14.07	A/V DESIGN CONCEPT
	6.01.07	REV.1
	6.13.07	REV.2
	11.10.07	AS-BUILT

COMMISSION NO.

PROJECT PHASE

Drawn By: NCV Checked By: JDL

A/V LAYOUT LOWER LEVEL, CONTROL ROOM, AND CATWALK

AV-2